
Sec. No. 6, Township 77, Range 28.

PORTION OF THE
N½ NW¼ NE¼ SE¼
SEC. 6-77-28 W 5TH P.M.

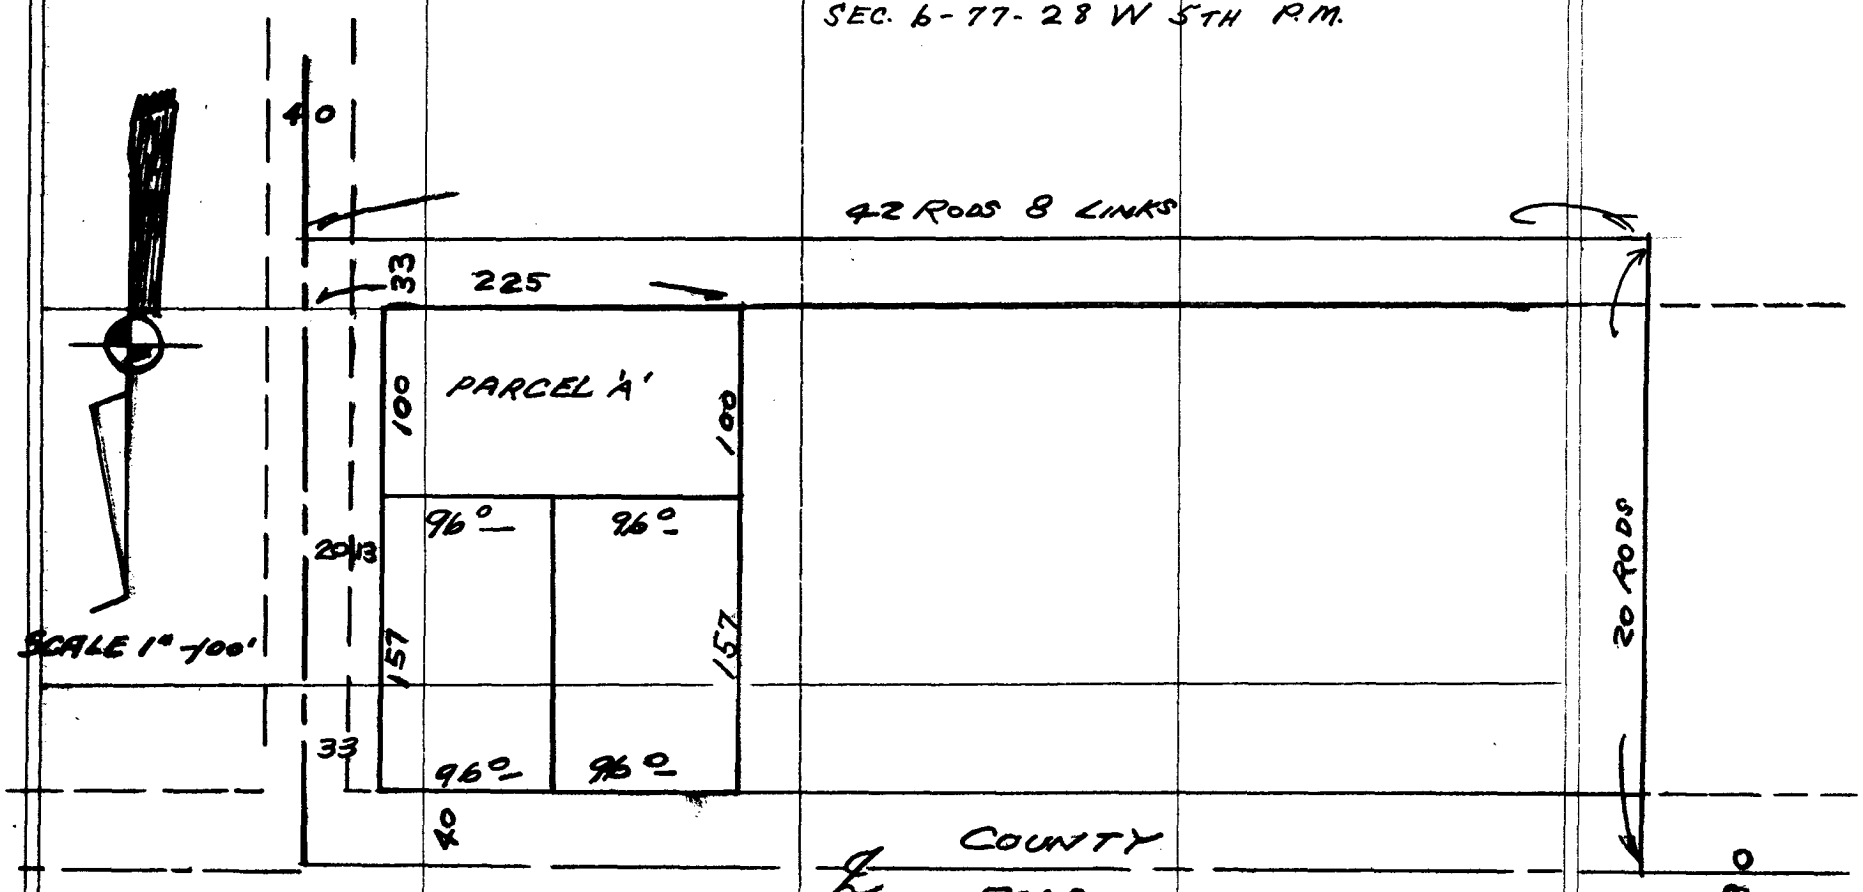

PROPERTY SUBDIVISION FOR B. COOK

Legal Description Parcel 'A'
THE NORTH 100' OF THE SOUTH 133' OF THE EAST 225' OF THE N½ NW¼ NE¼ SE¼ OF SEC. 6 TWP 77 N - RGE 28 W OF 5TH P.M.

Filed for record 24 day of April 1968 at 10:56 A.M. # 629
Mary E. Welty Recorder
1.50

DRAWN JC SCALE 1"=100'
DATE 4-17-68
No. 68005
TITLE JOHN B. CHAPMAN LS 5541 ADEL IOWA

(SEAL)

CERTIFICATE

I CERTIFY THIS PLAT TO BE A TRUE REPRESENTATION OF A SURVEY MADE BY ME A DULY REGISTERED LAND SURVEYOR IN THE STATE OF IOWA + IS TRUE + CORRECT TO THE BEST OF MY KNOWLEDGE.