Document 2019 993

Book 2019 Page 993 Type 06 043 Pages 1
Date 4/08/2019 Time 11:23:17AM
Rec Amt $7.00

LISA SMITH, COUNTY RECORDER
MADISON COUNTY IOWA

INDX
ANNO
SCAN
CHEK

Prepared by: Vincent E. Piagentini, Abaci Consulting Inc, 101 NE Circle Dr, Grimes IA, 50111; (515)986-5048

UNITED STATES PUBLIC LAND SURVEY CORNER CERTIFICATE


of

LAND SURVEY MONUMENTS SITUATED IN SECTION 32, TOWNSHIP 74 N, RANGE 28 W, of the Fifth Principal Meridian, Madison County, Iowa.


Monument Description & Remarks:

SW Cor SE1/4 SE1/4 – searched, found nothing – set 1/2" IR YC 15982 – set equidistant and online between the SE Corner of Section 32 and the S1/4 of Section 32

PLAN VIEW

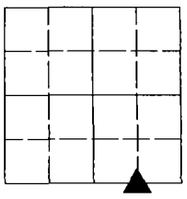

32-74-28

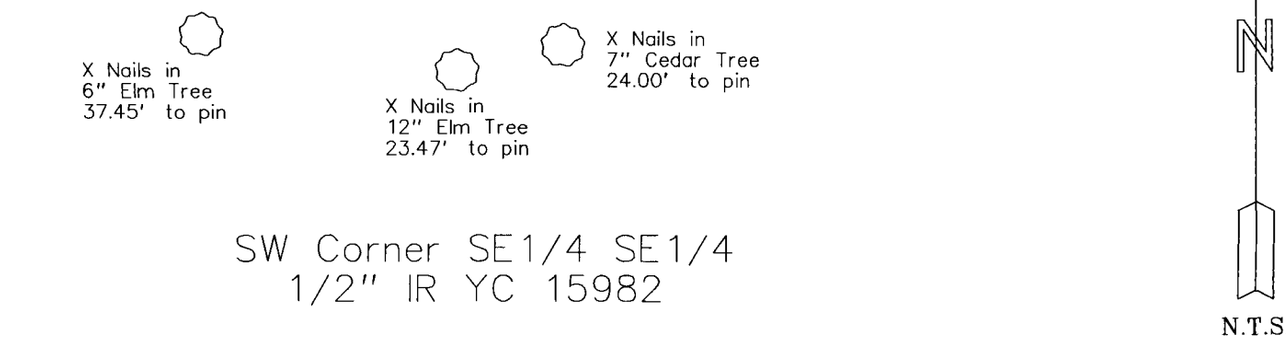

19044

I HEREBY CERTIFY THAT THIS SURVEYING DOCUMENT WAS PREPARED AND THE RELATED WORK WAS PERFORMED BY ME OR UNDER MY DIRECT PERSONAL SUPERVISION, AND THAT I AM A DULY LICENSED PROFESSIONAL LAND SURVEYOR UNDER THE LAWS OF THE STATE OF IOWA.

4/4/19

VINCENT E. PIAGENTINI, IOWA LIC. NO 15982 DATE

MY LICENSE RENEWAL DATE IS DECEMBER 31, 2020.

ADDITIONAL PAGES CERTIFIED (NONE UNLESS INDICATED HERE) This sheet only.

VINCENT E. PIAGENTINI LICENSED 15982 IOWA PROFESSIONAL LAND SURVEYOR

Corners to be Indexed:

Corner	Section	Twp	Range
SW Cor SE1/4 SE1/4	32	74	28
NW Cor NE1/4 NE1/4	5	73	28